



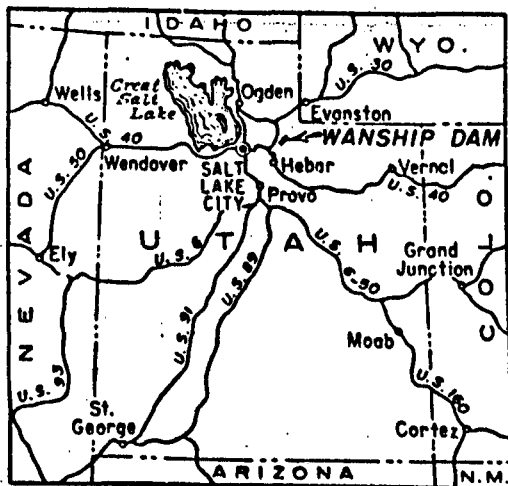

KEY MAP

5-1-58
D.B.7.2

AS BUILT BY 412, LETTER 4-2-58.

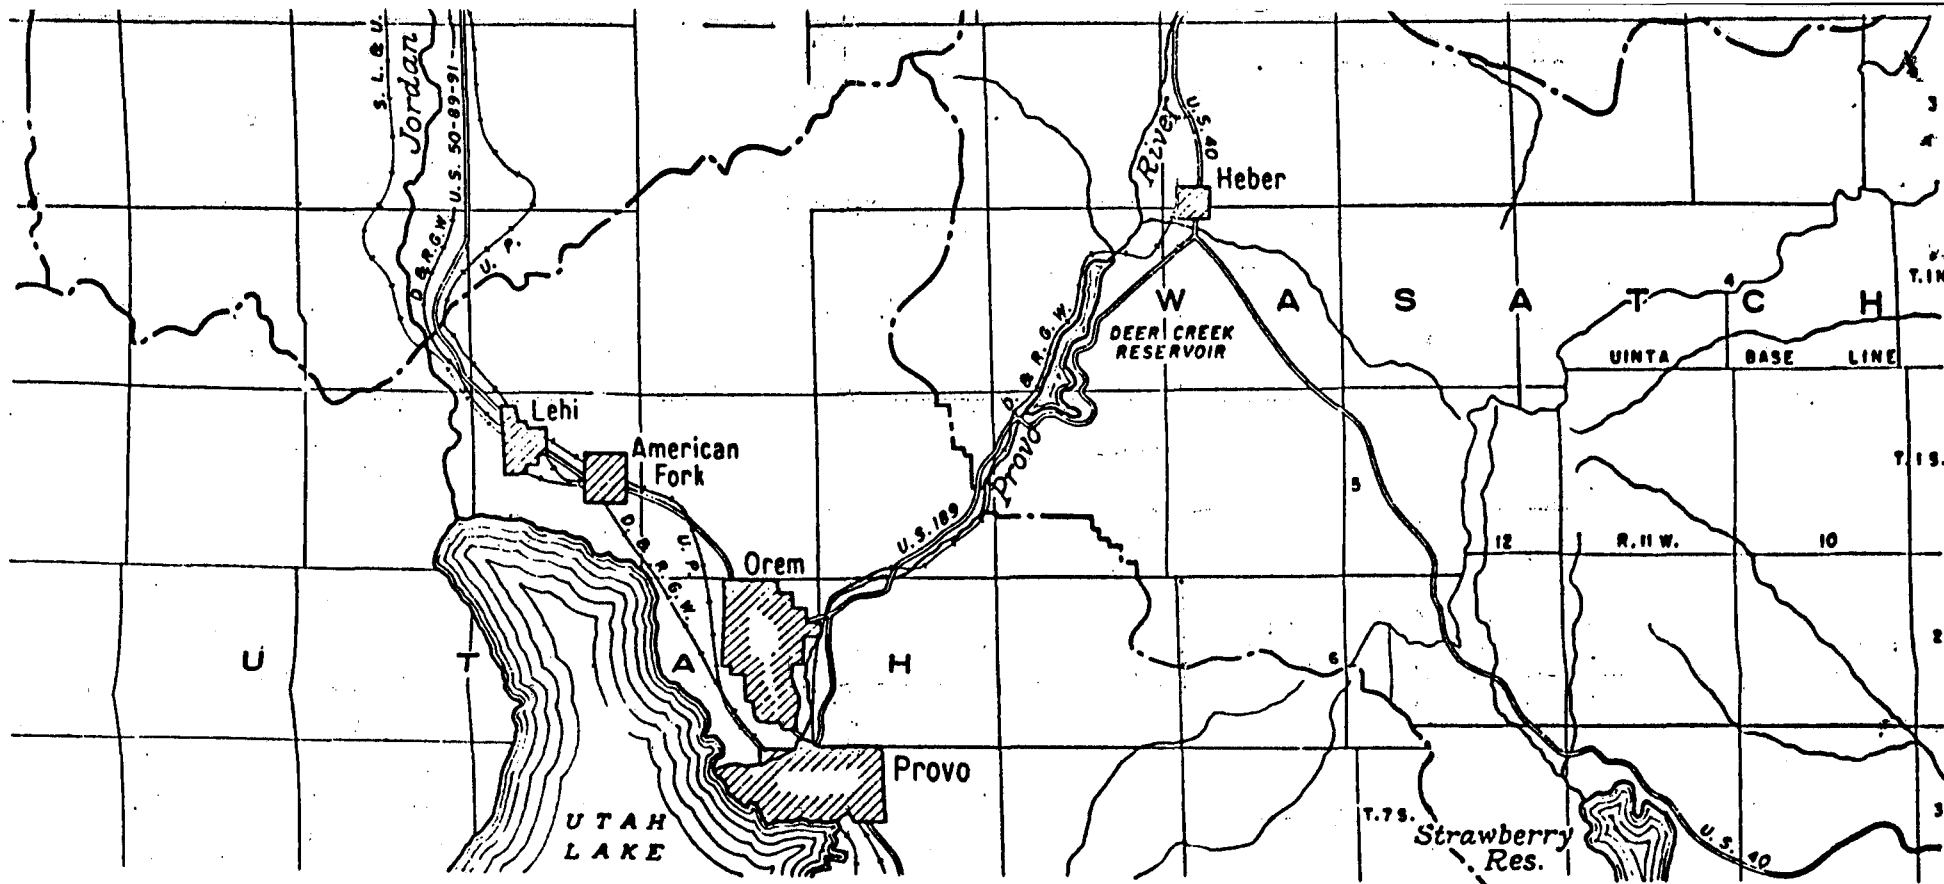



SCALE OF MILES
ALWAYS THINK SAFETY

UNITED STATES
DEPARTMENT OF THE INTERIOR
BUREAU OF RECLAMATION
WEBER BASIN PROJECT - UTAH
WANSHIP DAM
LOCATION MAP

DRAWN.....B.F.W.....SUBMITTED.....*Frank C. Walker*
TRACED.....B.F.W.....RECOMMENDED.....*W.M. Leach*
CHECKED.....*E.R. F.C.W.*.....APPROVED.....*Grant B. Leonard*
28400, CHIEF, P.E.

DENVER, COLORADO, JANUARY 18, 1954

526-D-126

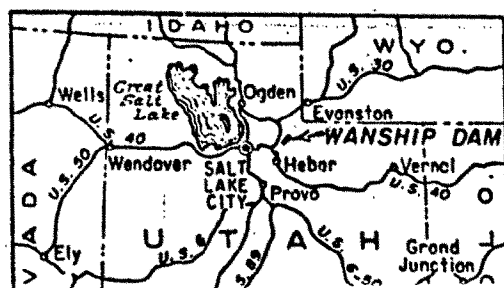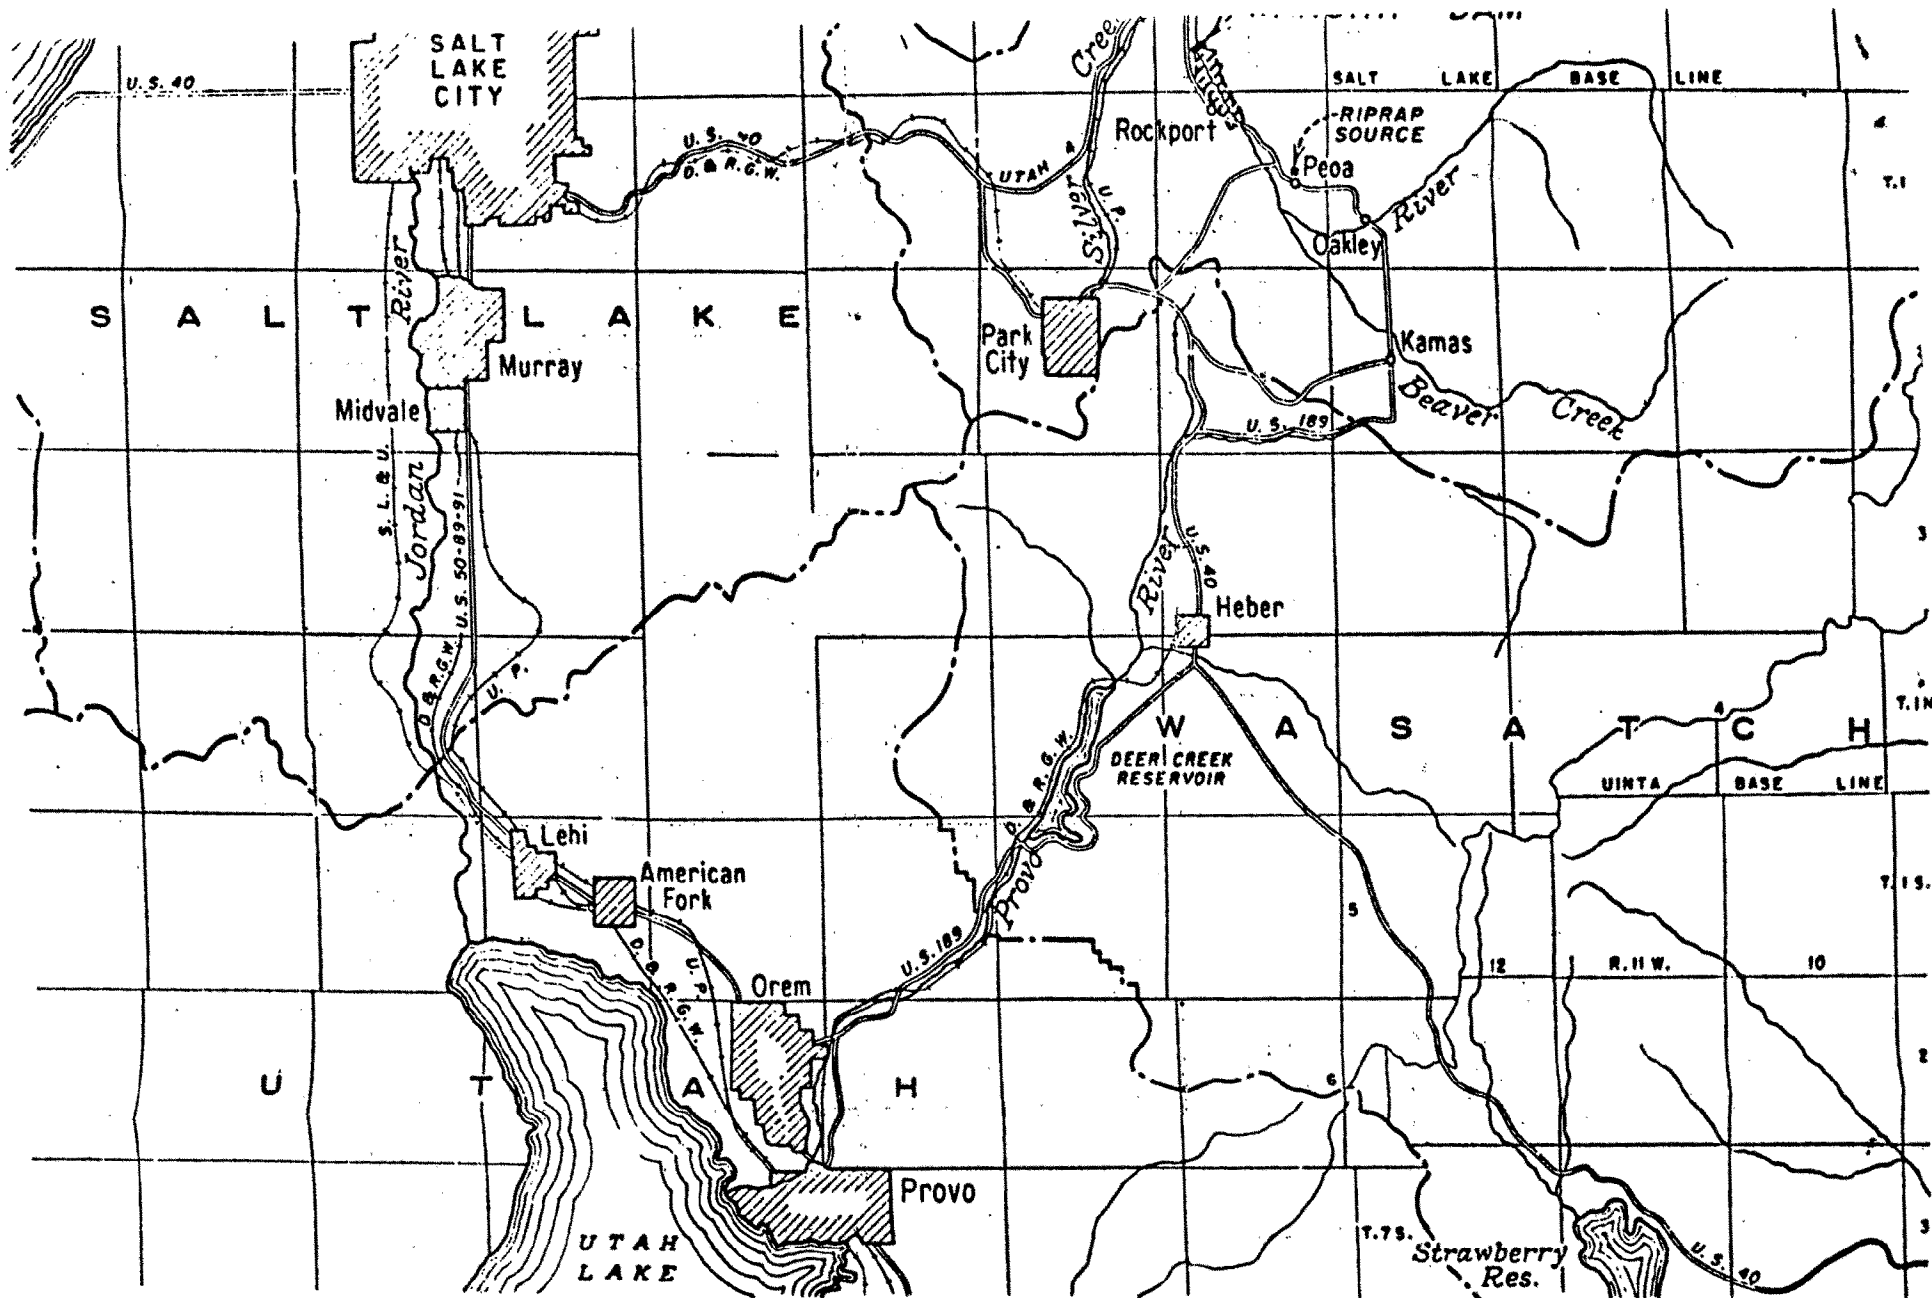

ALWAYS THINK SAFETY

UNITED STATES
DEPARTMENT OF THE INTERIOR
BUREAU OF RECLAMATION
WEBER BASIN PROJECT - UTAH

