

Hite Crossing 1:100,000

HIM

✓✓ ~~MR 1409~~

✓✓ ~~MR 1420~~

✓✓ ~~MR 1470~~

✓✓ ~~Jackson and Noller, 1987~~

✓✓ ~~MR 886~~

✓✓ ~~MR 1020~~

✓✓ ~~Unpublished~~ 1:125,000 landslide map, Colton

✓✓ ~~MR 1401~~

Appendix A. References Used To Compile The Map

~~SAME~~
~~TO APB~~ Colton, R.B., no date, Unpublished landslide mapping in the Escalante 1° X 2° quadrangle: ^{Utah} U.S. Geological Survey unpublished map, scale 1:125,000.

~~BULL~~
MR 1409 Davidson, E.S., 1967, Geology of the Circle Cliffs area, Garfield and Kane Counties, Utah: U.S. Geological Survey Bulletin 1229, 140 p., Plate 1, scale 1:48,000.

~~BULL~~
MR 1020 Finnell, T.L., Franks, P.C., and Hubbard, H.A., 1963, Geology, ore deposits, and exploratory drilling in the Deer Flat area, White Canyon district, San Juan County, Utah: U.S. Geological Survey Bulletin 1132, 114 p., Plate 1, scale 1:24,000.

~~SAME~~
(MR 2045) Jackson, M.D., and Noller, J.S., 1991, Geologic map of the Copper Creek Benches quadrangle, Utah: Utah Geological and Mineral Survey Open-File Report 209, 44 p., scale 1:24,000.

MR 1420 Larson, M.J., Bromfield, C.S., Dubiel, R.F., Patterson, C.G., and Peterson, Fred, 1985, Geologic map of the Little Rockies Wilderness Study Area and the Mount Hillers and Mount Pennell Study Areas, and vicinity, Garfield County, Utah: U.S. Geological Survey Miscellaneous Field Studies Map MF-1776-B, scale 1:50,000.

MR 1401 Larson, M.J., Bromfield, C.S., Dubiel, R.F., Orkild, P.P., Patterson, C.G., and Peterson, Fred, 1985, Geologic maps of the Fiddler Butte Wilderness Study Area and the Fremont Gorge Study Area, Garfield and Wayne Counties, Utah: U.S. Geological Survey Miscellaneous Field Studies Map MF-1755-B, scale 1:50,000.

MR 1470 Oviatt, C.G., 1991, Quaternary geology of the Black Rock Desert, Millard County, Utah: Utah Geological and Mineral Survey Special Study 73, 23 p., scale 1:100,000.

~~BULL~~
MR 886 Thaden, R.E., Trites, A.F., and Finnell, T.L., 1964, Geology and ore deposits of the White Canyon area, San Juan and Garfield Counties, Utah: U.S. Geological Survey Bulletin 1125, 166 p., Plate 1, scale 1:48,000.

Richfield 30' x 60'


HITE CROSSING, UTAH

1-10105
Lush & Lake
unaffiliated




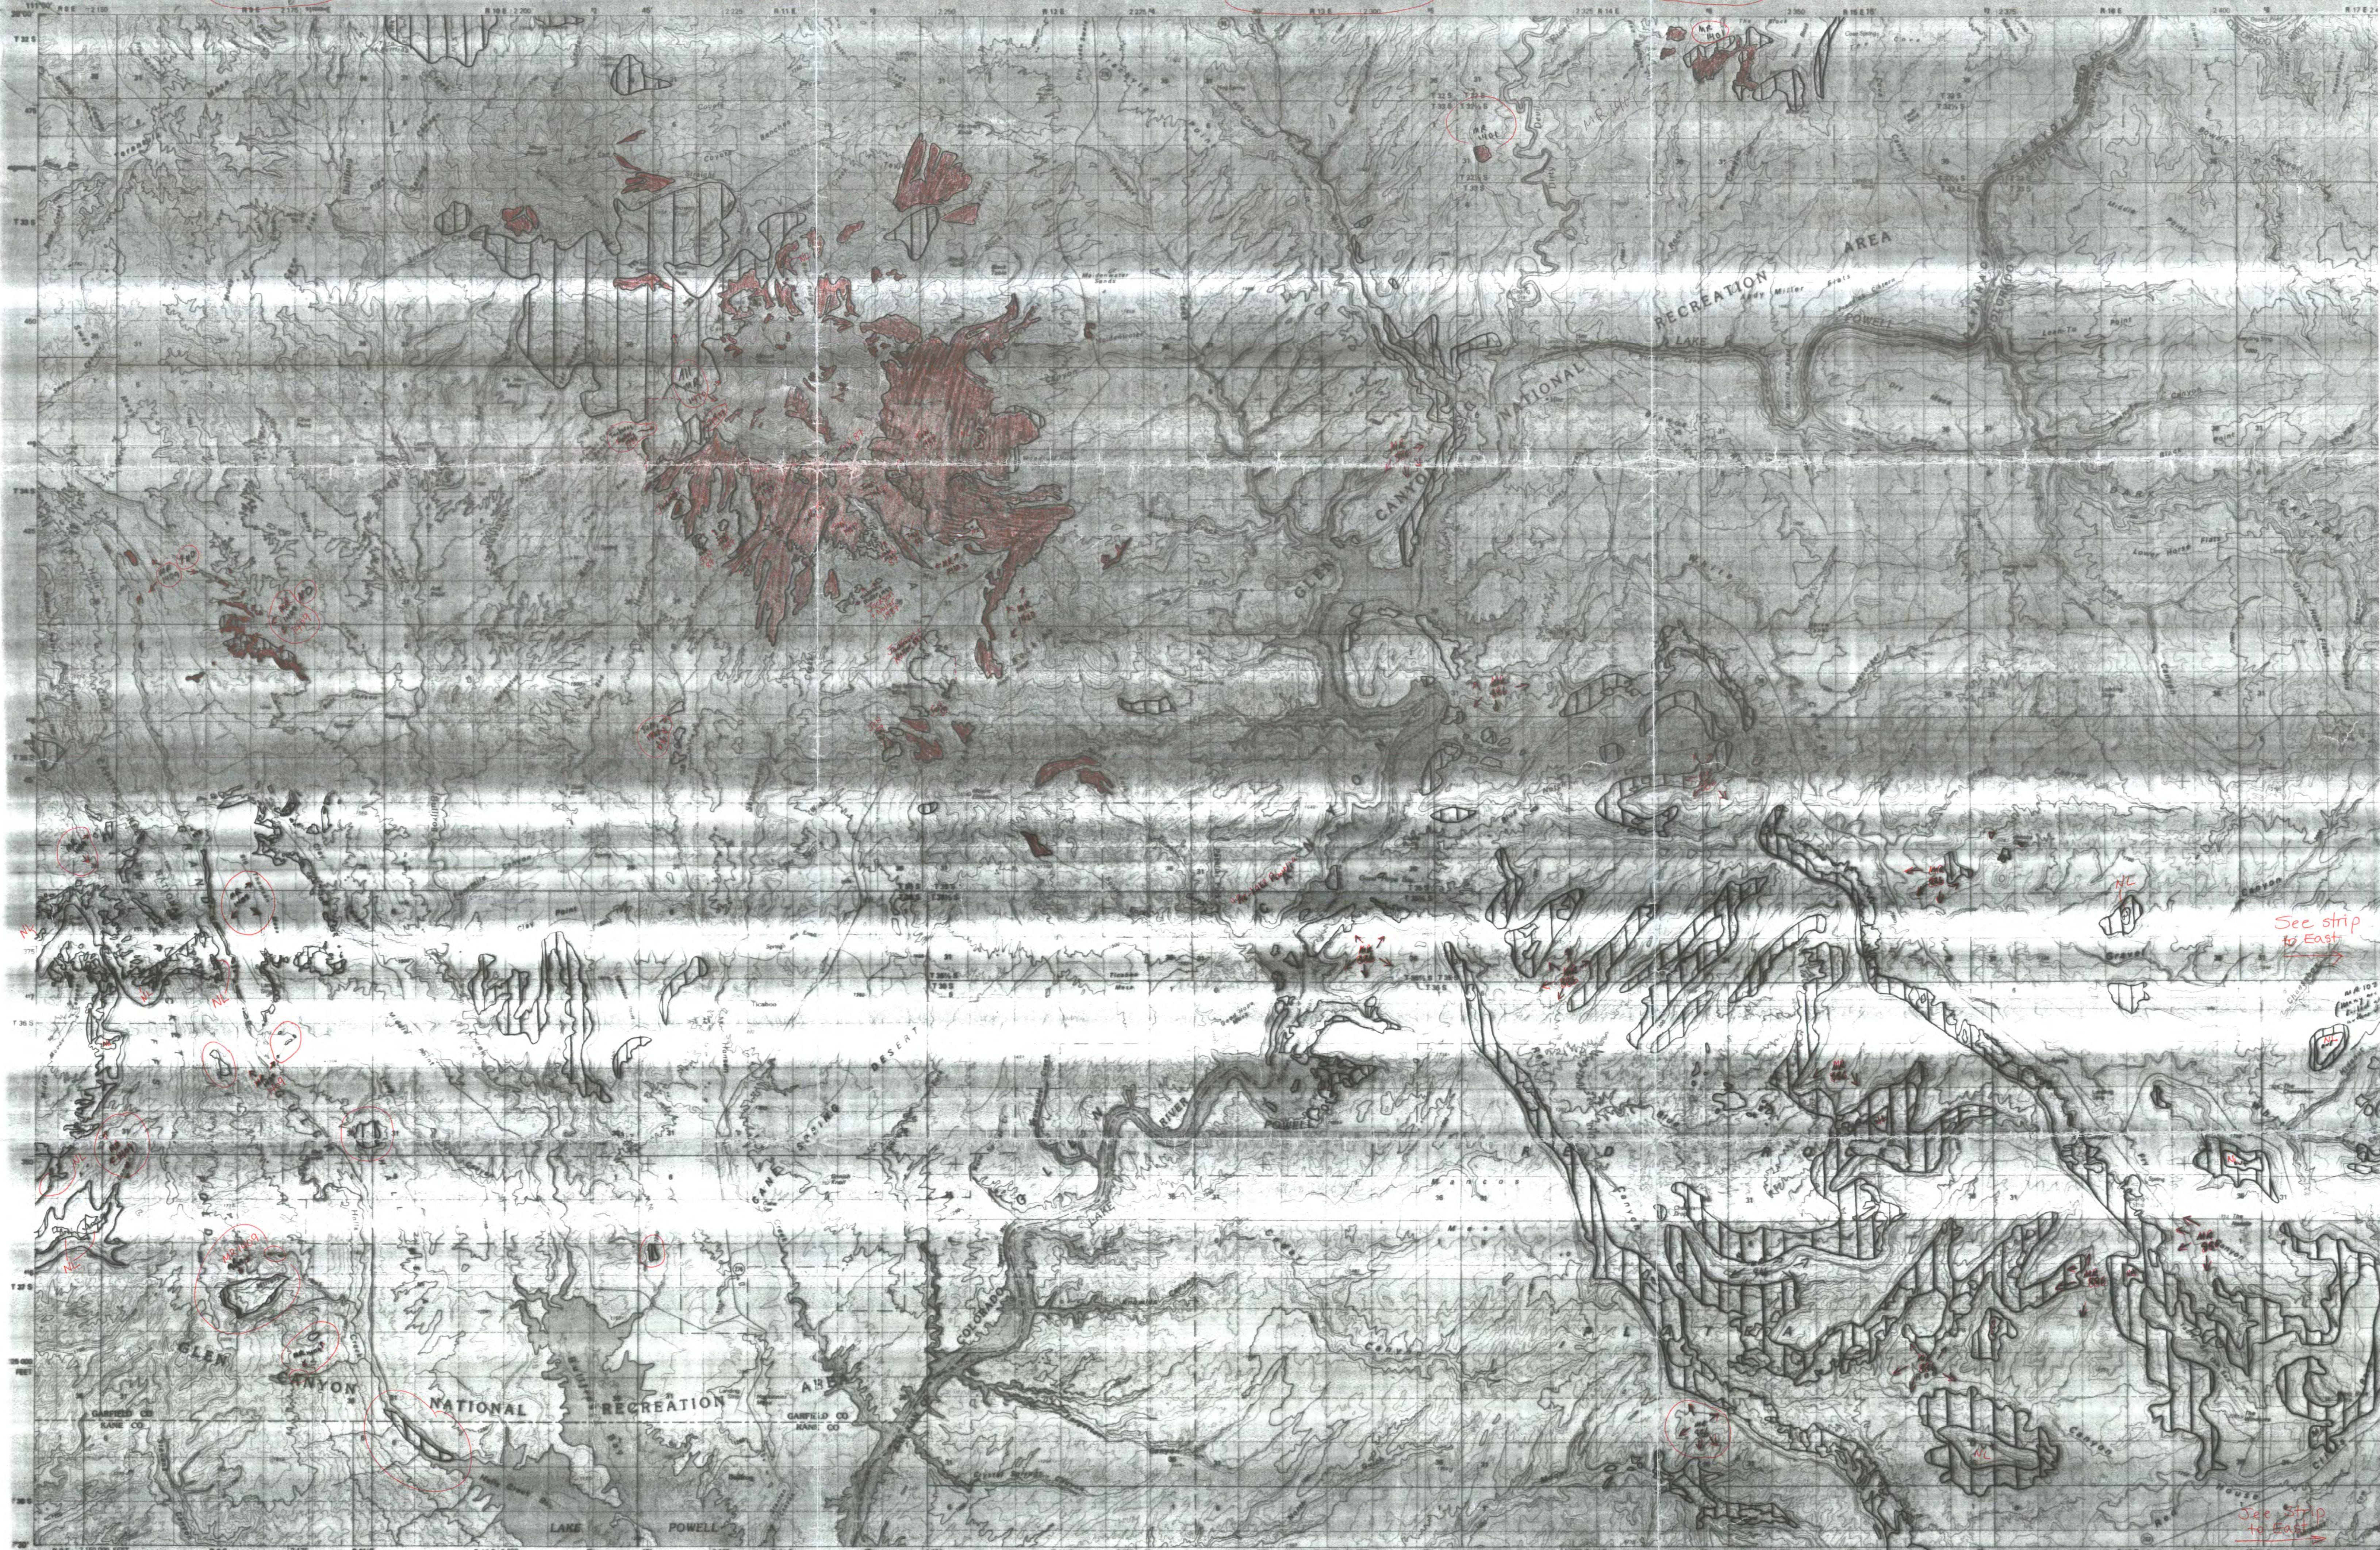


See strip
to East

See strip
to East

SCALE 1:100,000

HITE CR
N

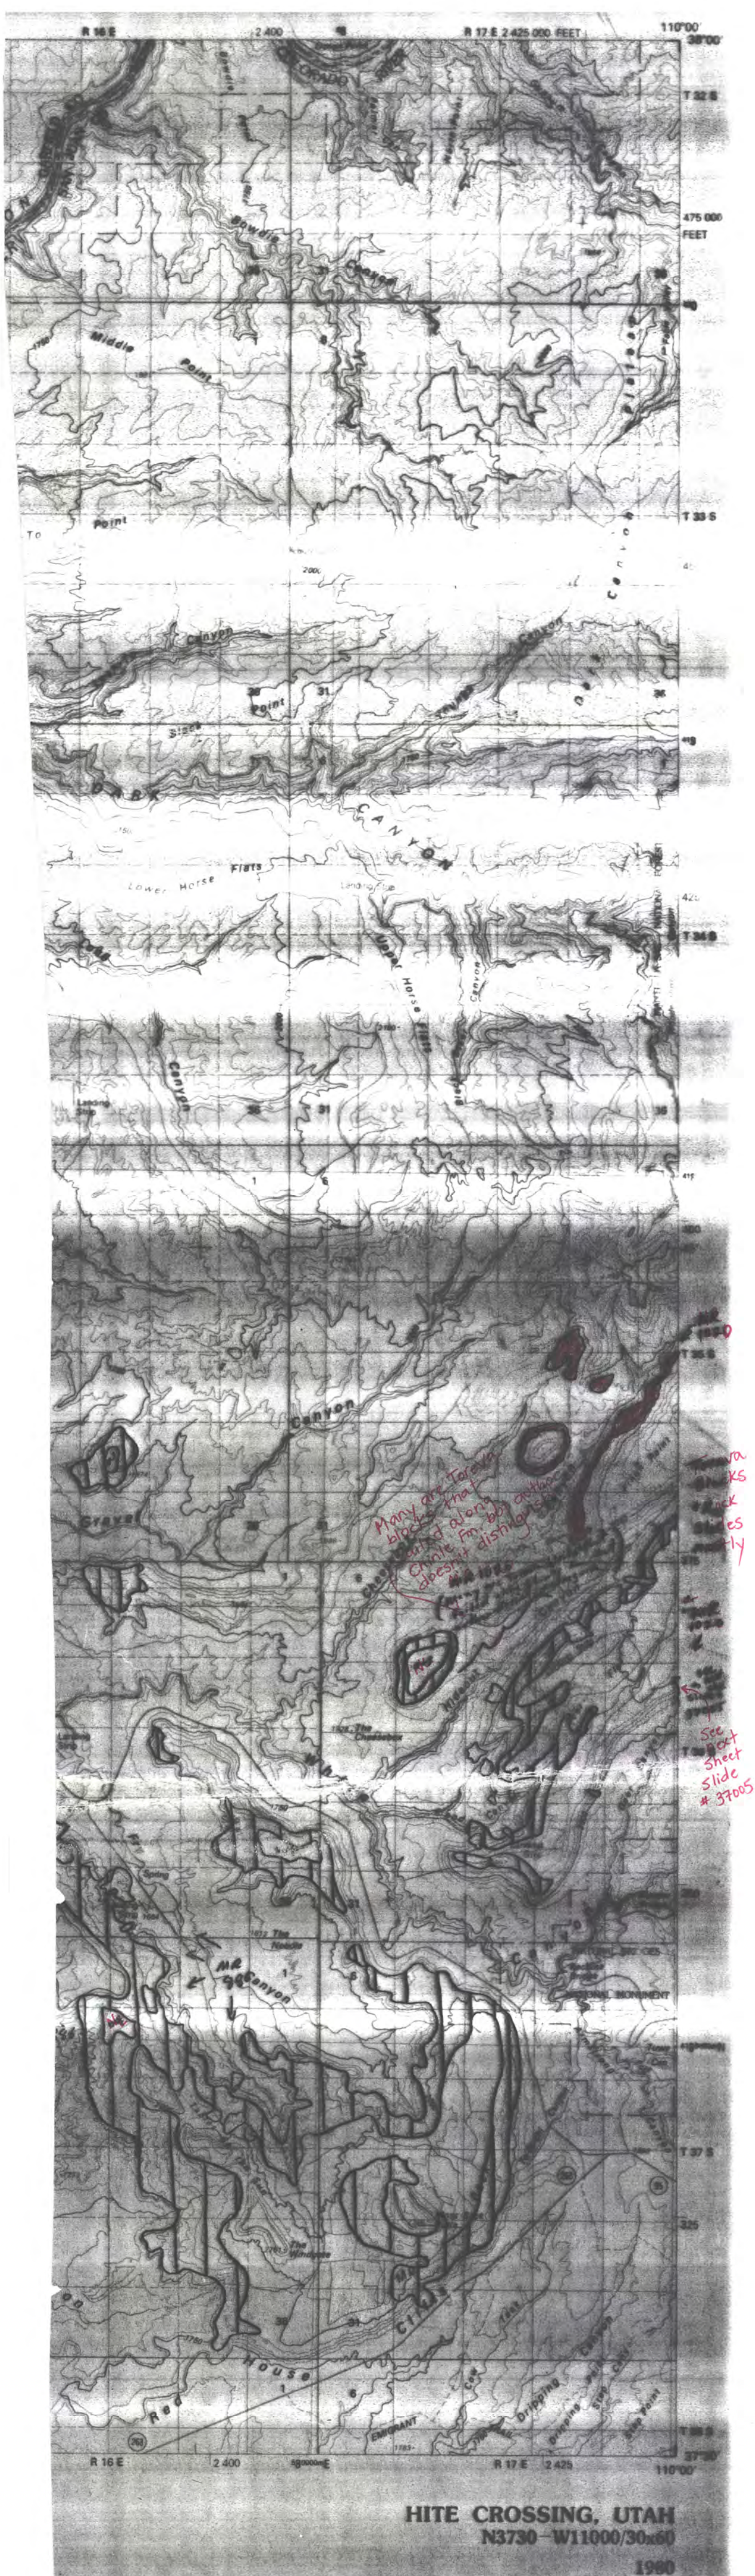

HITE CROSSING, UTAH
N3730-W11000/30x60
1980