
Utah Geological Survey
in cooperation with the
U.S Geological Survey

OPEN-FILE REPORT

Denise Please add
Kd - Kcm contact
shown in pencil
near middle

MOAB, UTAH–COLORADO

30X60 MINUTE SERIES (TOPOGRAPHIC)

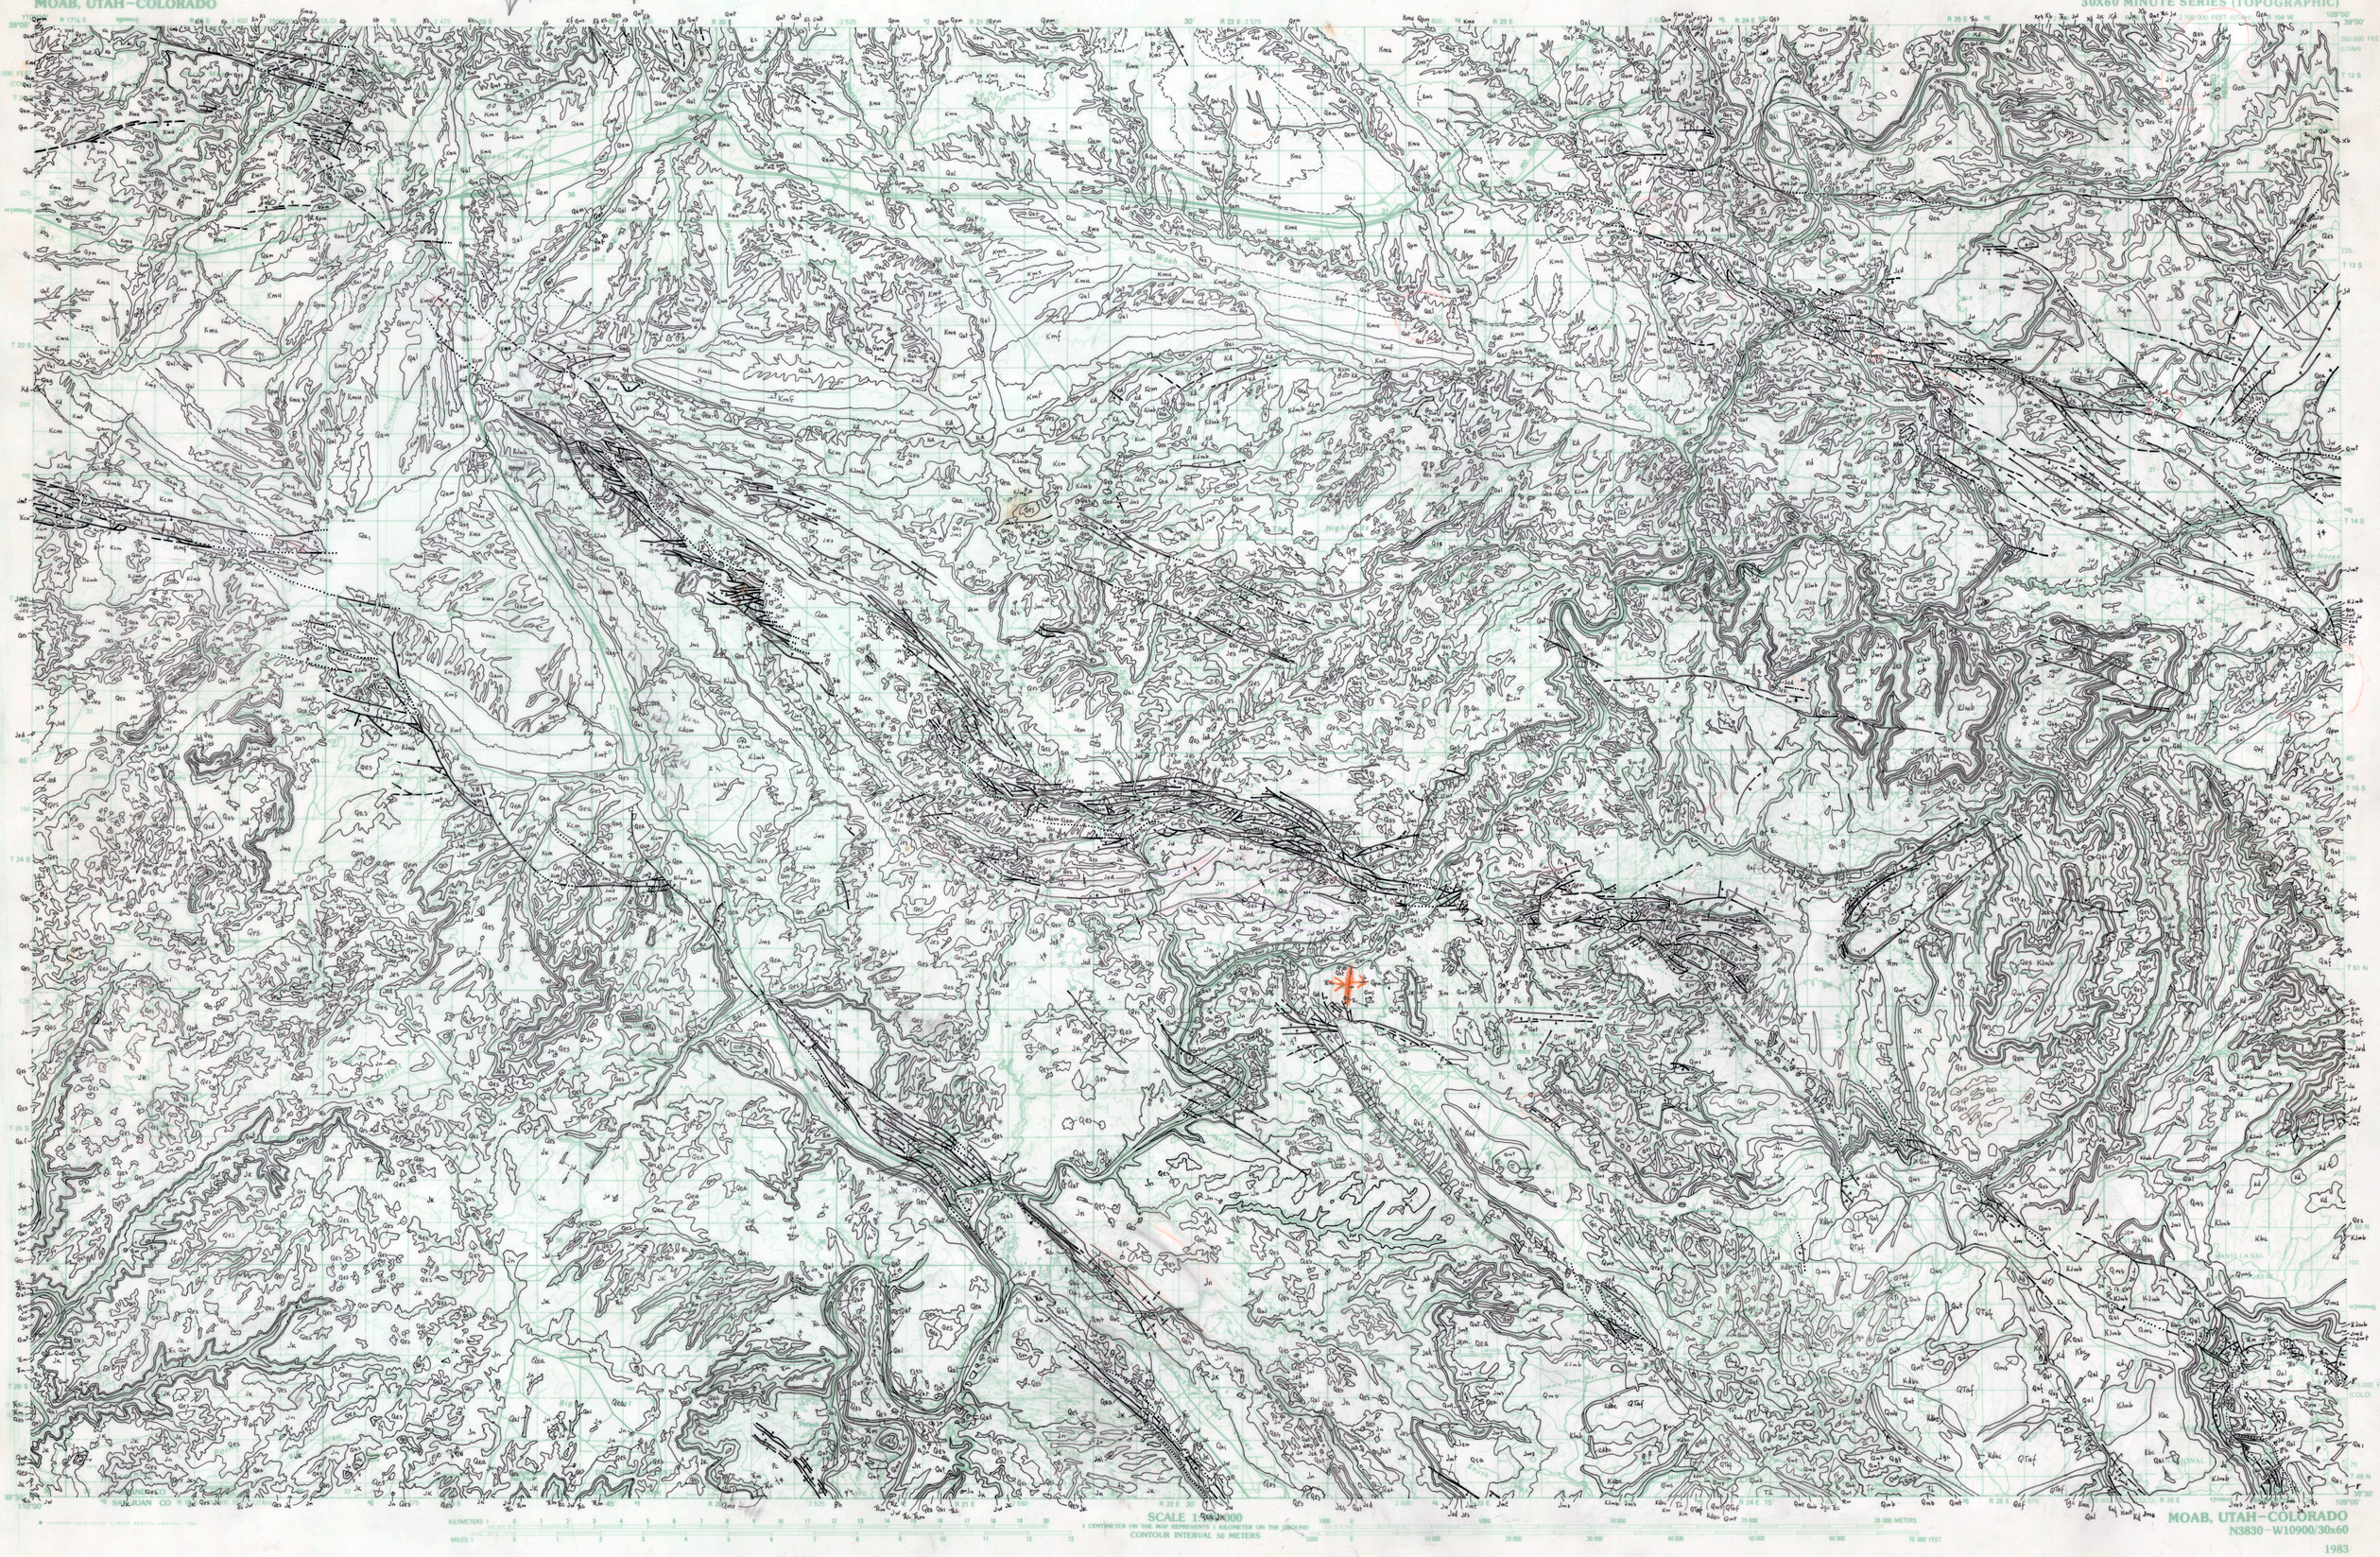

SCALE 1:100,000
1 CENTIMETER ON THE MAP REPRESENTS 1 KILOMETER ON THE GROUND
CONTOUR INTERVAL 50 METERS

MOAB, UTAH–COLORADO
N3830–W10900/30x60

1983

INTERIM GEOLOGIC MAP, MOAB 30'x 60' QUADRANGLE, GRAND COUNTY, UTAH AND MESA COUNTY, COLORADO

by Hellmut H. Doelling

Utah Geological Survey July 1993 Open-File Report 287